

Duplication of this document and the use or communication of the contents thereof are forbidden without express authority. Offenders are punishable and liable to the payment of damages. All rights are reserved in the event of the grant of a patent or the registration of a utility model.


CTQ table					Z	DECISION (A,B,C)
DETAIL SPEC.		TOLERANCE		TARGET Z (3~6)		
NO.	ITEM	SIZE	+	-		
NO.	DESCRIPTION	Q'TY	DRAWING NO.		REMARK	
49	PAD LOWER SPEAKER	1	MPBN0019201			
50	FILTER LOWER SPEAKER	1	MFBC0013501			
51	PAD LOWER MOTER	1	MPBJ0022701			
52	COVER LOWER	1	MCJH0024701			
53	TAPE LOWER DECO	1	MTAA0070001			
54	TAPE MAIN WINDOW	1	MTAD0033701			
55	HINGE	1	MHFD0010501			
56	LOWER DECO	1	MDAF0006201			
57	MAIN WINDOW	1	MWAC0049201			
58	VIBRATOR, MOTOR (12pi)	1	SJMY0002604			
59	SPEAKER (17pi)	1	SUSY0013801			
60	CAP SCREW UP L	1	MCCH0044501			
61	CAP SCREW UP R	1	MCCH0044601			
62	TAPE DECO RECEIVER	1	MTAA0070301			
63	DECO RECEIVER	1	MDAH0011501			
64	CAP SCREW DOWN L	1	MCCH0044701			
65	CAP SCREW DOWN R	1	MCCH0044801			
66	SCREW MACHINE(M1.4*3.0)	4	GMEY0002001			
67	PAD BAR	1	MPBZ0095801			
68	CAMERA SHIELD FORM	1	MGAD0079001			
69	FOLDER INSERT	4	MICA0014701			
70	TAPE MOD FRAME	1	MTAZ0058301			
71	TAPE PROTECTION SUB_02	1	MIDA0017601			
72	ANTENNA	1	SNMF0016001			
73	INSULATION TAPE MODKEY	1	MIDZ0059801			
74	TAPE MODKEY	1	MTAZ0080001			
75	PAD MOD FRAME	1	MPBZ0082701			
76	TAPE PROTECTION SUB	1	MIDA0016801			
77	TAPE PROTECTION CAMERA	1	MIDZ0065001			
78	SHIELD FORM FPCB UPPER	1	MGAD0087801			
79	SHIELD FORM FPCB LOWER	1	MGAD0091301			
80	PAD MOD	1	MPBZ0082901			
81	PAD ANTENNA UP	1	MPBZ0076301			
82	PAD ANTENNA DOWN	1	MPBZ0091201			

NO.	DESCRIPTION	Q'TY	DRAWING NO.	REMARK
83	CAP REAR	1	MCCZ0012301	
84	PAD FPCB(EPDM)	1	MPBZ0095501	
85	SCREW MACHINE(M1.4*3.0)	4	GMEY0002001	
86	TAPE PROTECTION LCD	1	MIDA0016701	
87	TAPE UPPER HINGE	1	MTAZ0088001	

ASSY(1)	COVER ASSY FOLDER(LOWER)	1	ACGH0030601
ASSY(2)	COVER ASSY FOLDER(UPPER)	1	ACGJ0042101
ASSY(3)	COVER ASSY FRONT	1	ACGK0048201
ASSY(4)	COVER ASSY REAR	1	ACGM0047901

REVISION				
ISSUE	CONTENTS	ENGINEER	APPROVER	DATE
I.0	THE FIRST TIME ISSUE	S H KIM	H C OH	05.05.12
I.1	(71) ITEM ADDITION (55) ITEM NUMBER CHANGE	S H KIM	H C OH	05.06.22
I.2	(87) ITEM ADDITION	S H KIM	H C OH	05.08.01

48	PAD MAIN LCD WINDOW	1	MPBG0030701	
47	LCD MODULE ASSY	1	SVLM0011201	
46	FRONT INSERT	4	MICA0014701	
45	LCD SHIELD FORM	2	MGAD0078601	
44	MOD FRAME	1	MFEZ0004801	
43	MAGNETIC SWITCH	1	AMAA0003901	
42	PAD SUB LCD WINDOW	1	MPBQ0020701	
41	CAMERA	1	SVCY0004501	
40	SHIELD FORM FPCB	1	MGAD0078701	
39	PAD CAMERA	1	MPBT0013701	
38	FUNTION KEY ASSY	1	AKAB0005301	
37	PAD UPPER MOTER	1	MPBJ0022801	
36	PAD UPPER SPEAKER	1	MPBN0017301	
35	COVER UPPER	1	MCJJ0031401	
34	TAPE CAMERA	1	MTAZ0058401	
33	TAPE UPPER DECO	1	MTAA0070501	
32	SHIELD FORM FRONT	1	MGAD0086701	
31	FILTER MIK	1	MFBD0008601	
30	TAPE SUB WINDOW	1	MTAE0021201	
29	SUB WINDOW	1	MWAF0025301	
28	UPPER DECO	1	MDAE0027501	
27	TAPE CAMERA DECO	1	MTAA0070401	
26	TAPE WINDOW CAMERA	1	MTAZ0059101	
25	WINDOW CAMERA	1	MWAE0007101	
24	DECO CAMERA	1	MDAD0010001	
23	DECO WINDOW CAMERA	1	MDAY0012101	
22	INSULATION TAPE REAR	1	MIDZ0060001	
21	STOPPER	1	MSGY0009901	
20	COVER BATTERY	1	MCJA0016601	
19	TAPE DECO FRONT_01	1	MTAA0070601	
18	COVER REAR	1	MCJN0032801	
17	CAP RE	1	MCCF0022701	
16	CAP EARJACK	1	MCCC0022101	
15	PAD MSM	1	MPBL0002901	
14	REAR SHIELD FORM	1	MGAD0078901	
13	BATTERY CONNECTOR	1	ENZY0013201	
12	FRONT SHIELD TAPE	1	MTAC0020901	
11	PCB ASSY	1	SAFY0110508	
10	DOME SHEET	1	ADCA0033901	
9	KEYPAD ASSY	1	AKAZ0008701	
8	HINGE GUIDE	1	MBIB0002501	
7	BUTTON ASSY R	1	MBJL0020101	
6	BUTTON ASSY L	1	MBJL0020001	
5	BUTTON ASSY PTT_KEY	1	MBJL0020201	
4	BUMPER	2	MBHY0012601	
3	COVER FRONT	1	MCJK0036701	
2	TAPE DECO FRONT_02	1	MTAA0093401	
1	DECO FRONT	1	MDAG0009801	

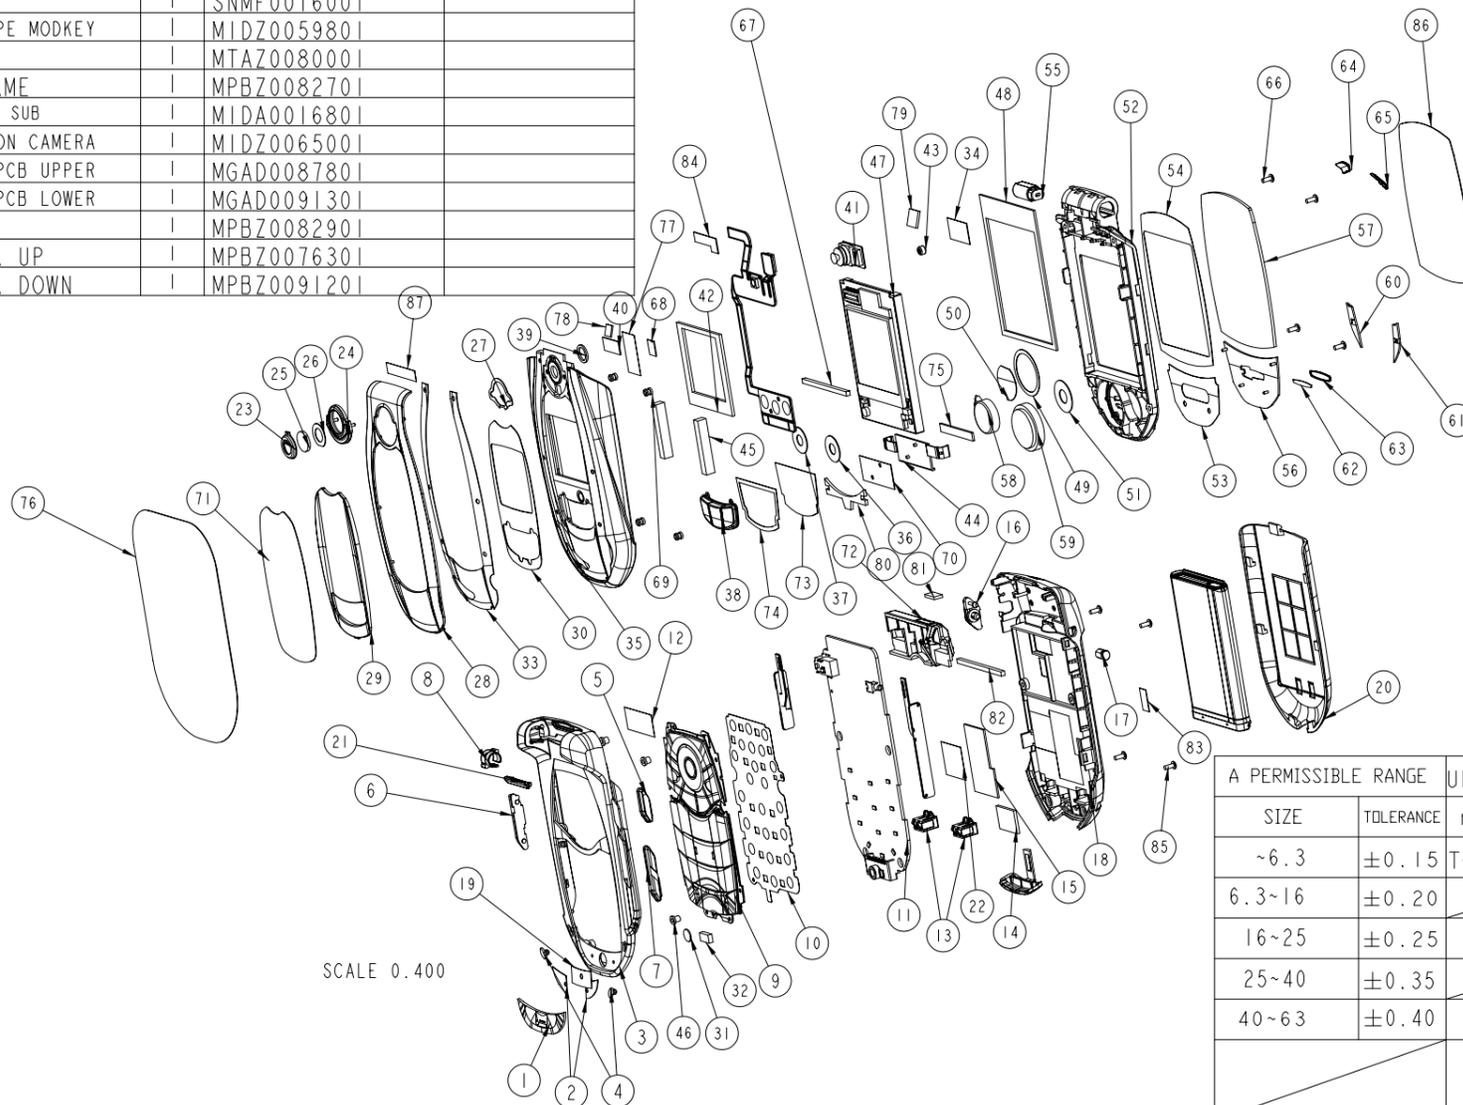

A PERMISSIBLE RANGE	UNIT	SCALE	NO.	DESCRIPTION	Q'TY	DRAWING NO.	REMARK
SIZE	TOLERANCE	mm	0.400	PARTS INDEX			
~6.3	±0.15	TOLERANCE	APP.	DATE	NAME	MATERIAL	
6.3~16	±0.20	FINISH	CHEC.		H C OH	REL DWG	
16~25	±0.25	DESIGN	DESIGN		S B LIM		
25~40	±0.35				S H KIM		
40~63	±0.40	F/N					
						DWG NAME	LG-MX500 PHONE
						DWG NO.	



A3

Change

- 2005. 3. 25  
C3 : DNI -> 0.5P
- 2005. 4. 23  
R1 : 0 -> 100P(C102)  
R4 : 0 -> 100P(C103)  
C7 : 8p -> 100p  
C12 : 12p -> 3.3n(L56)  
C17 : 100e -> 1.5p  
L4 : 3.9n -> 8.2n  
L6 : 3.9n -> 3.9n  
F1 : DSA3219A-19.2M -> ERF3003B1(X1)  
U10 : MK30081075 -> VC-SR8281-1751J  
position change : L43 (-> C26)


Add

- 2005. 3. 25  
R44 : 1K

- PCS TX (Blue line)
- DCN TX (Red line)
- PCS RX (Yellow line)
- DCN RX (Green line)


Delete

- 2005. 3. 25  
C102 : DNI

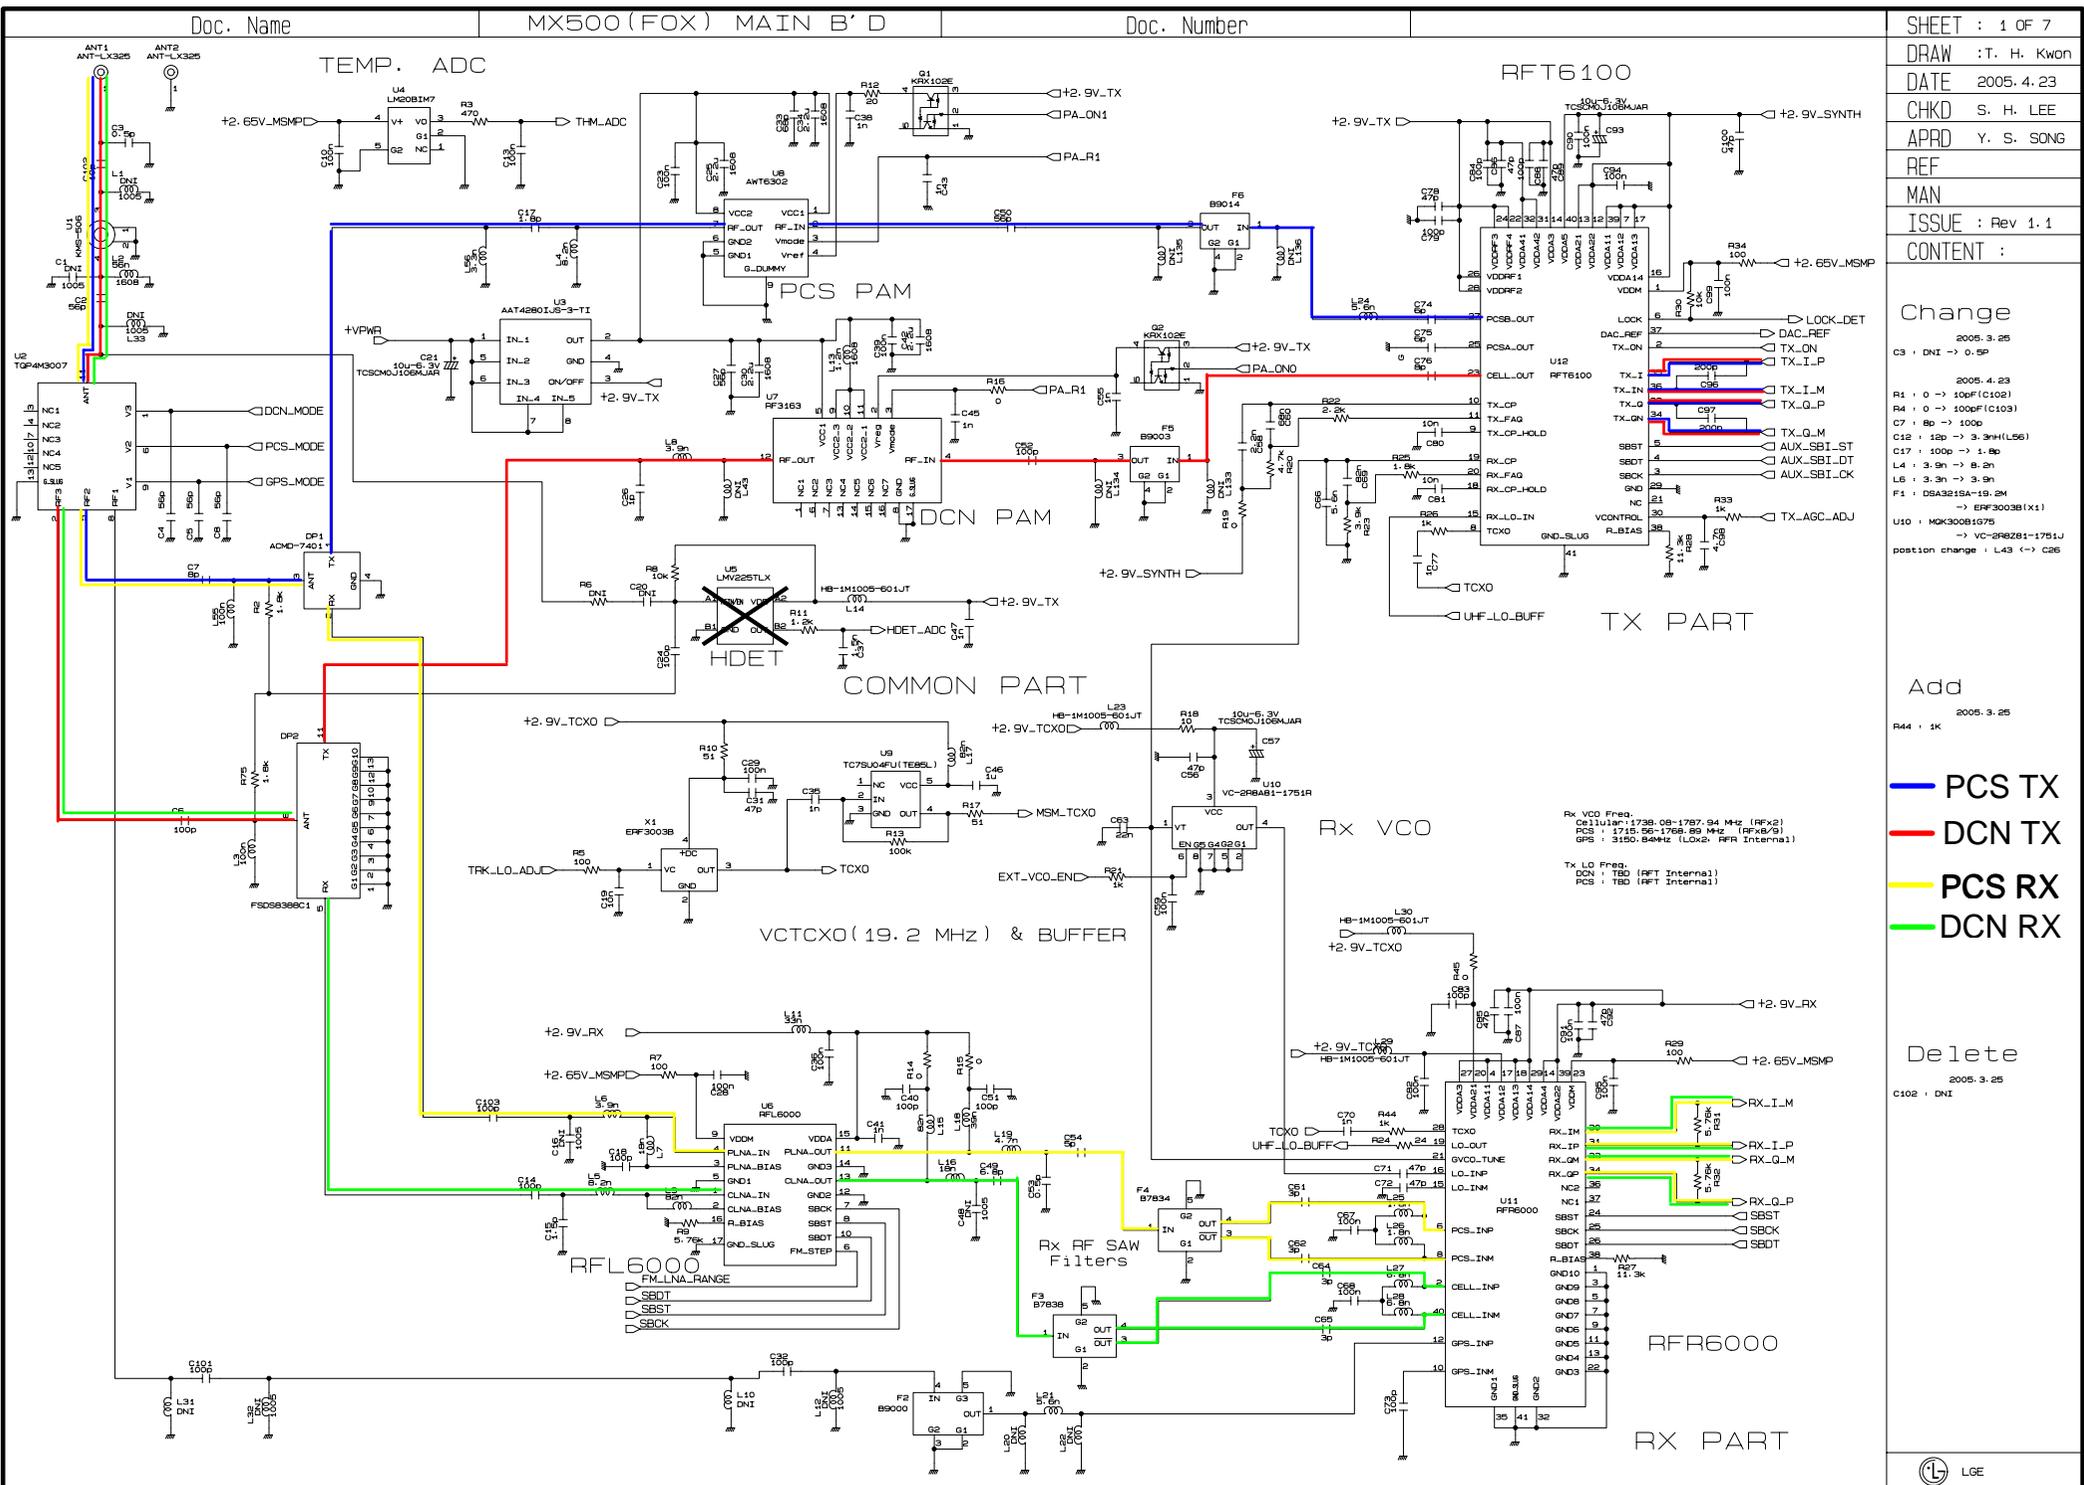





MEMORY  
(NAND 1G + SDRAM 256M)

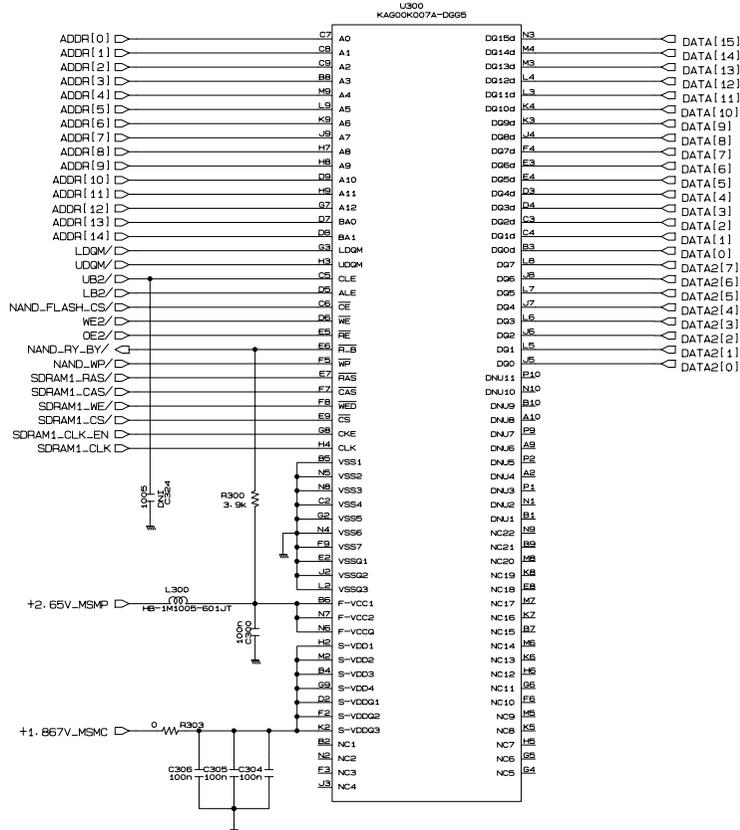


< AUDIO AMP >

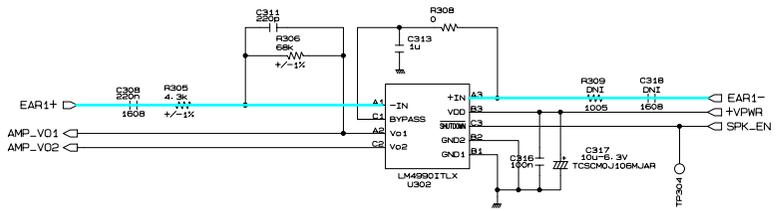


< AUDIO SWITCH >

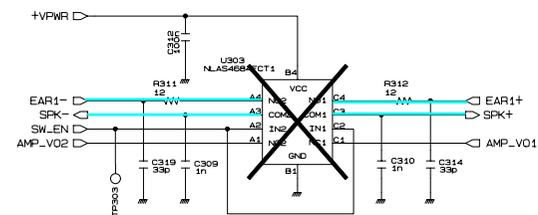

< FOLDER SENSOR SW >

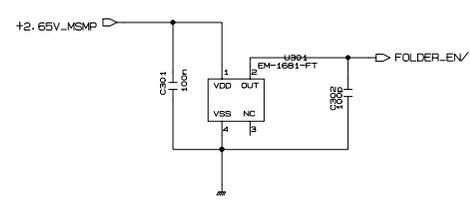

CAMERA OSCILLATOR

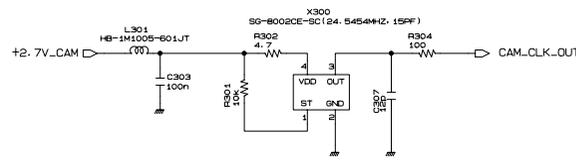

Change

2005. 3. 25  
 C318 : 220n(1608) -> DNI  
 R305 : 4.7k -> 4.7k(1X)  
 R306 : 68k -> 68k(1X)  
 AUDIO PATH CHANGE  
 U301 : EC2648F -> EM-1661-FT


Add

2005. 3. 25  
 C319 : 33p  
 TP304

Delete

2005. 3. 25  
 R310 : R307

### POWER MANAGEMENT IC

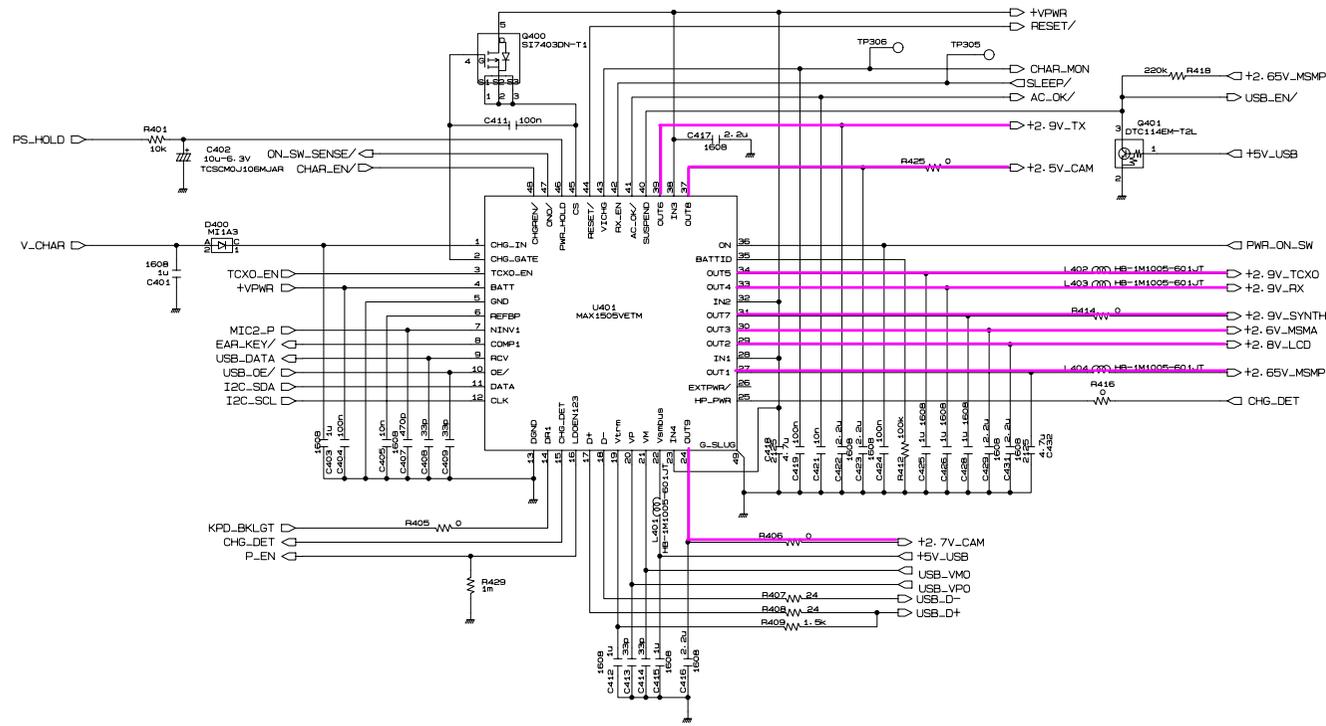

Inner Charger  
 9 LDos  
 1 Driver  
 1 Comparator  
 Reset  
 USB Transceiver  
 I2C Interface  
 Power Switch Circuit


### Change

2005. 4. 23  
 C401, C403, C412, C415, C425, C426, C428 -> C1608V5V1A105ZT  
 -> GRM39X5R105K6.3PT  
 C400, C416, C417, C422, C423, C429, C431 -> C1608V5V1A25ZT  
 -> GRM39X5R25K6.3

### Add

2005. 3. 25  
 R429 : 1M


### < MOTOR >

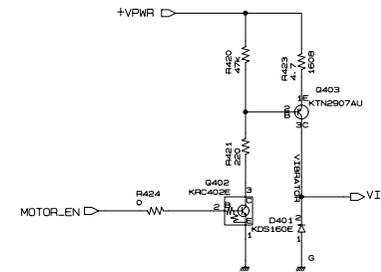


### Delete

2005. 4. 23  
 C433


### +1.867V MSMC DC/DC

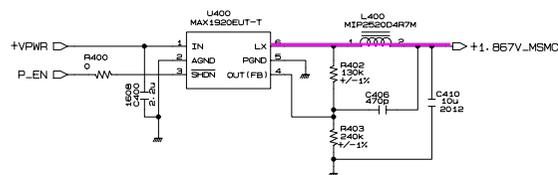

### WHITE LED DC/DC

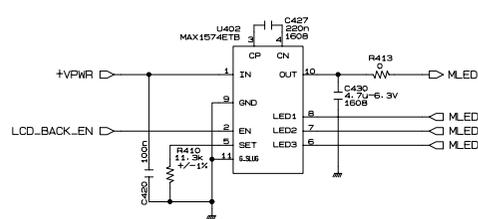


### C/F CHARGE PUMP

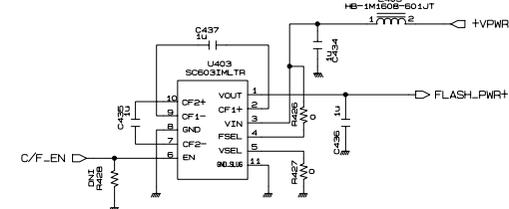





### EAR BUTTON DETECTION

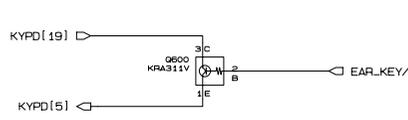


### POWER SWITCH

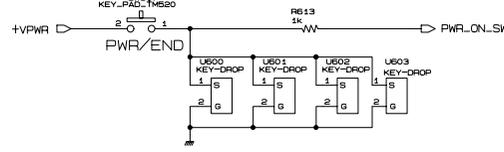



### SIDE KEY (RIGHT)

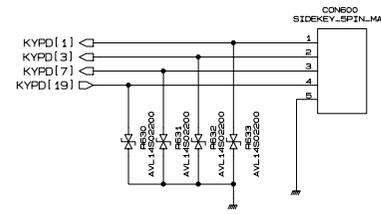


### SIDE KEY (LEFT)

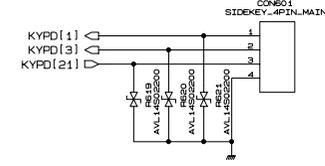

### KEY PAD CIRCUIT

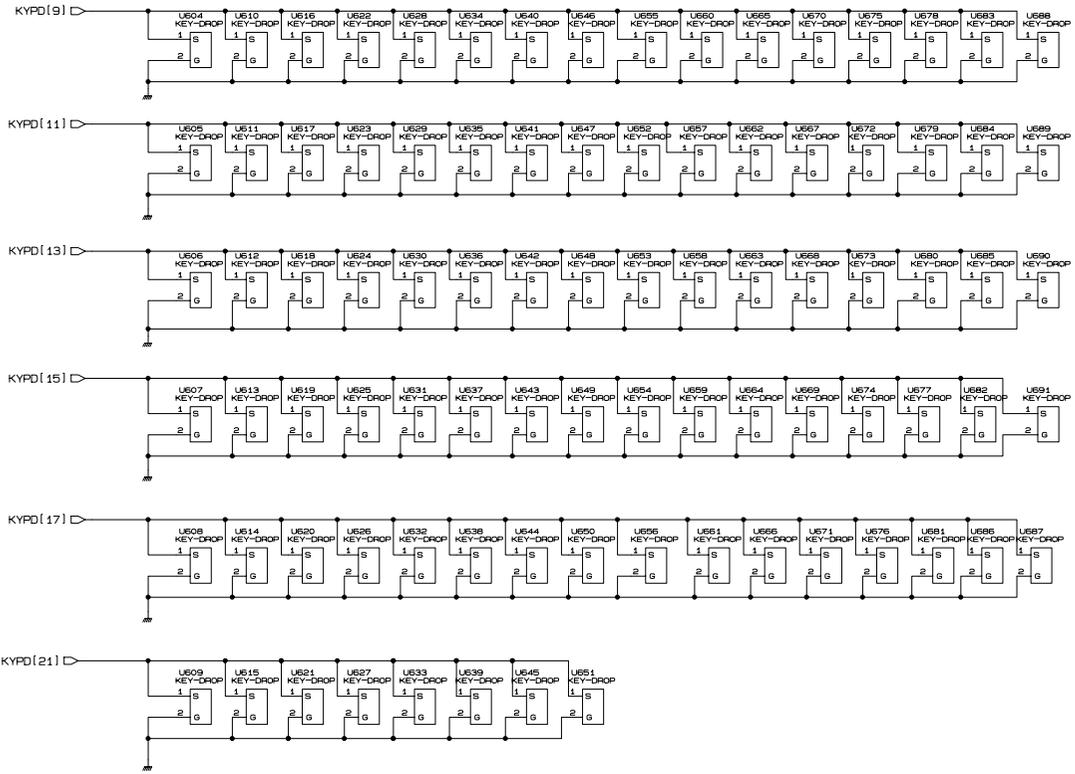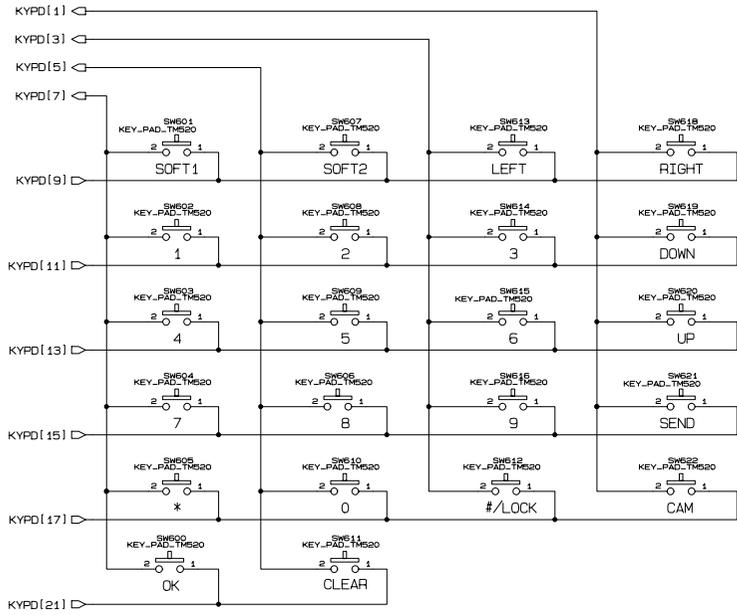

### KEY PAD BACKLIGHT CIRCUIT


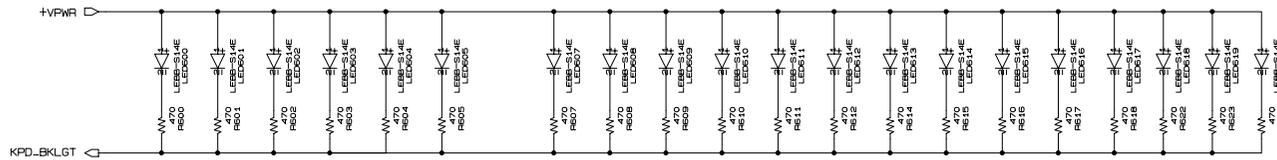


Change

Add

Delete

# <FPCB 70 PIN CONNECTOR>

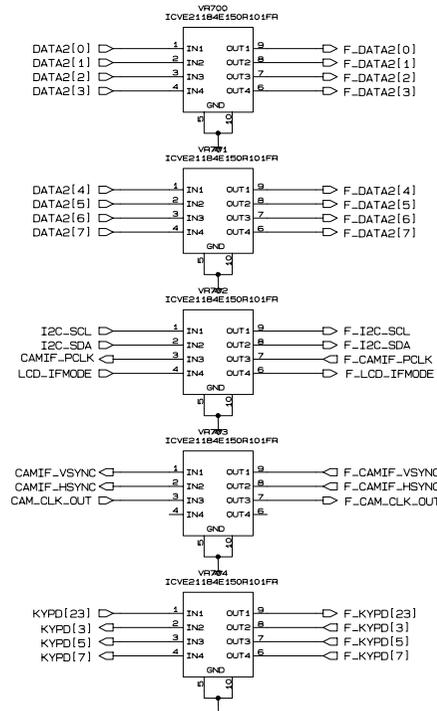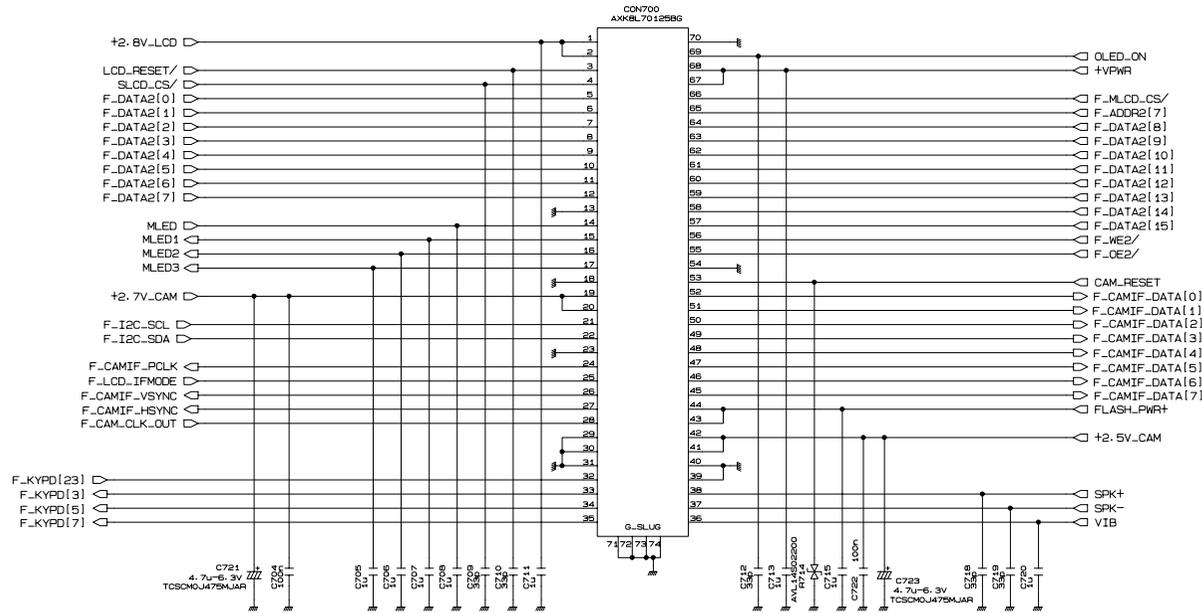

Change

Add

Delete



# THE BOTTOM OF MAIN PCB (MX500)

U300  
Memory  
No booting


U200  
MSM6100  
No Power  
Sleeping decrease

U12  
RFT6100  
No Tx Transmission

U7  
DCN Power AMP  
Low Tx Power  
No Service  
No Calling

U8  
PCS Power AMP  
Low Tx Power  
No Service  
No Calling

DP1  
PCS Duplexer  
DP2  
DCN Duplexer  
No Service  
No Calling

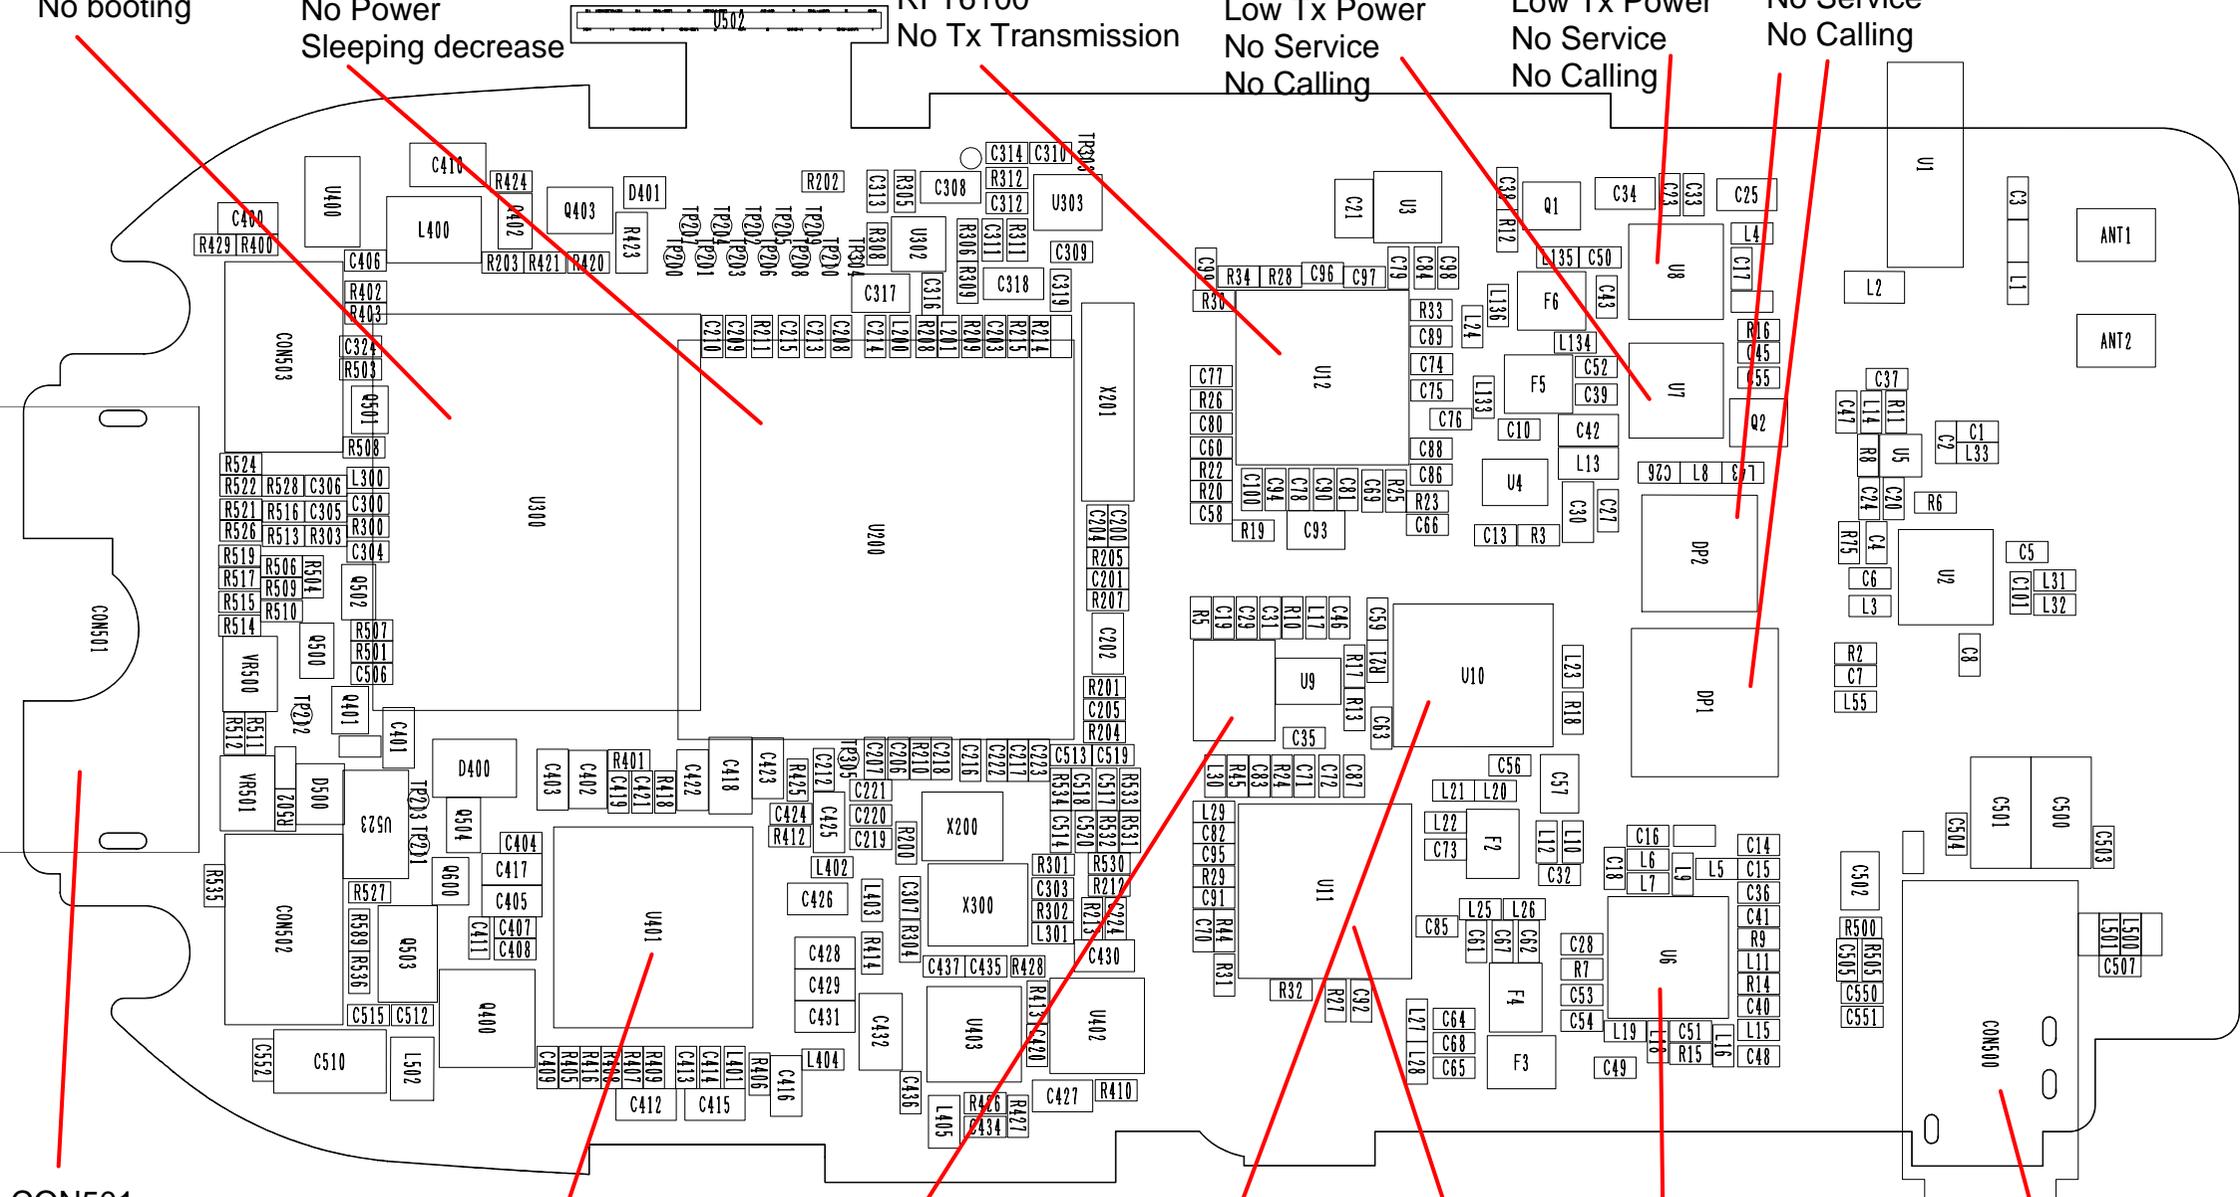

CON501  
Receptacle & DC Jack  
No DM Connect  
Charging unable

U401  
MAX1505VETM  
No booting  
No Power  
No Charging

X1  
TCXO(19.2MHz)  
No Wake up  
No service

U10  
VCO  
No Local Frequency

U11  
RFR6000  
Low sensitivity  
No service

U6  
RFL6000  
Low sensitivity  
No service

CON500  
Ear Jack  
Ear Jack unable